



DANBURY JD-GA COURTHOUSE
MASONRY RESTORATION - PHASE II

146 WHITE STREET
DANBURY, CONNECTICUT

Revisions
01/09/2019 - ADDENDUM #2

Date 10/26/2018
Scale As Noted
Project Number 15103
Drawn By JCS

LP.1

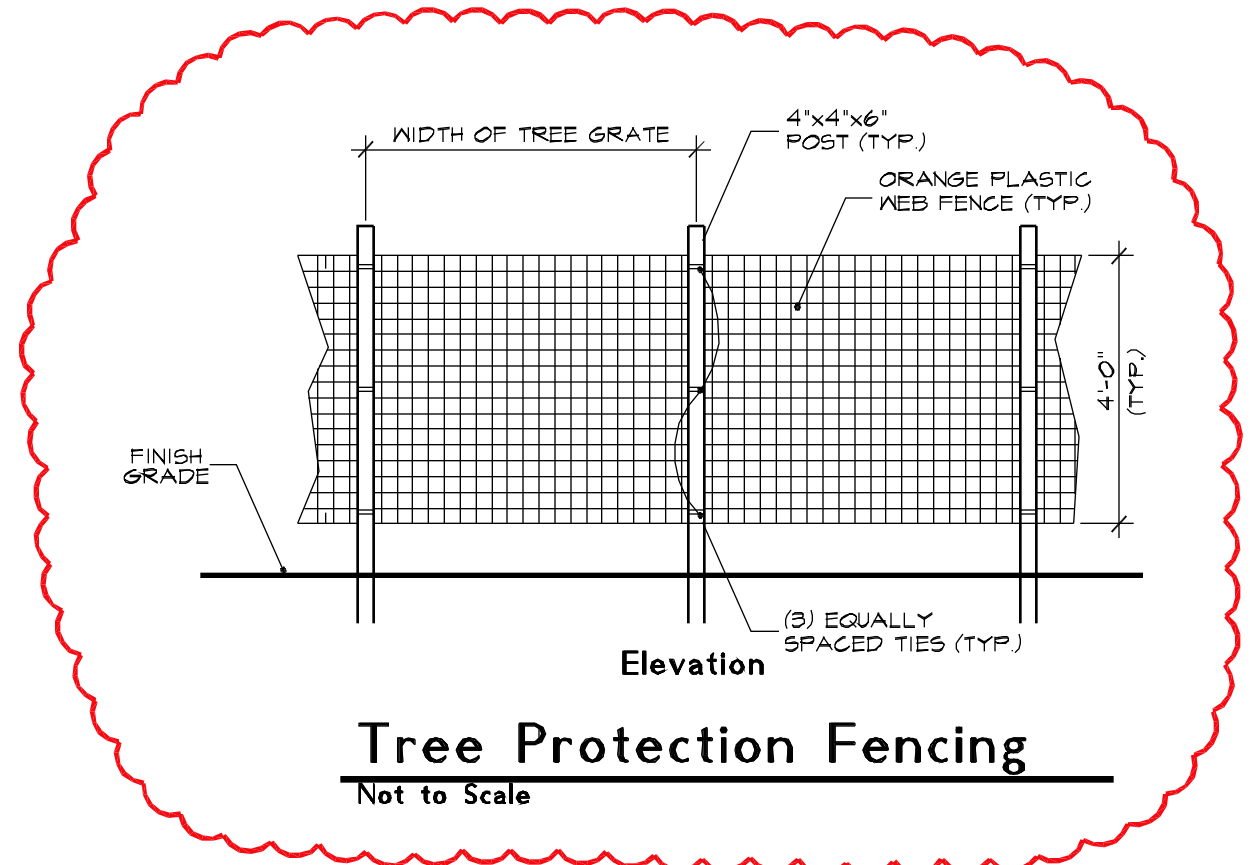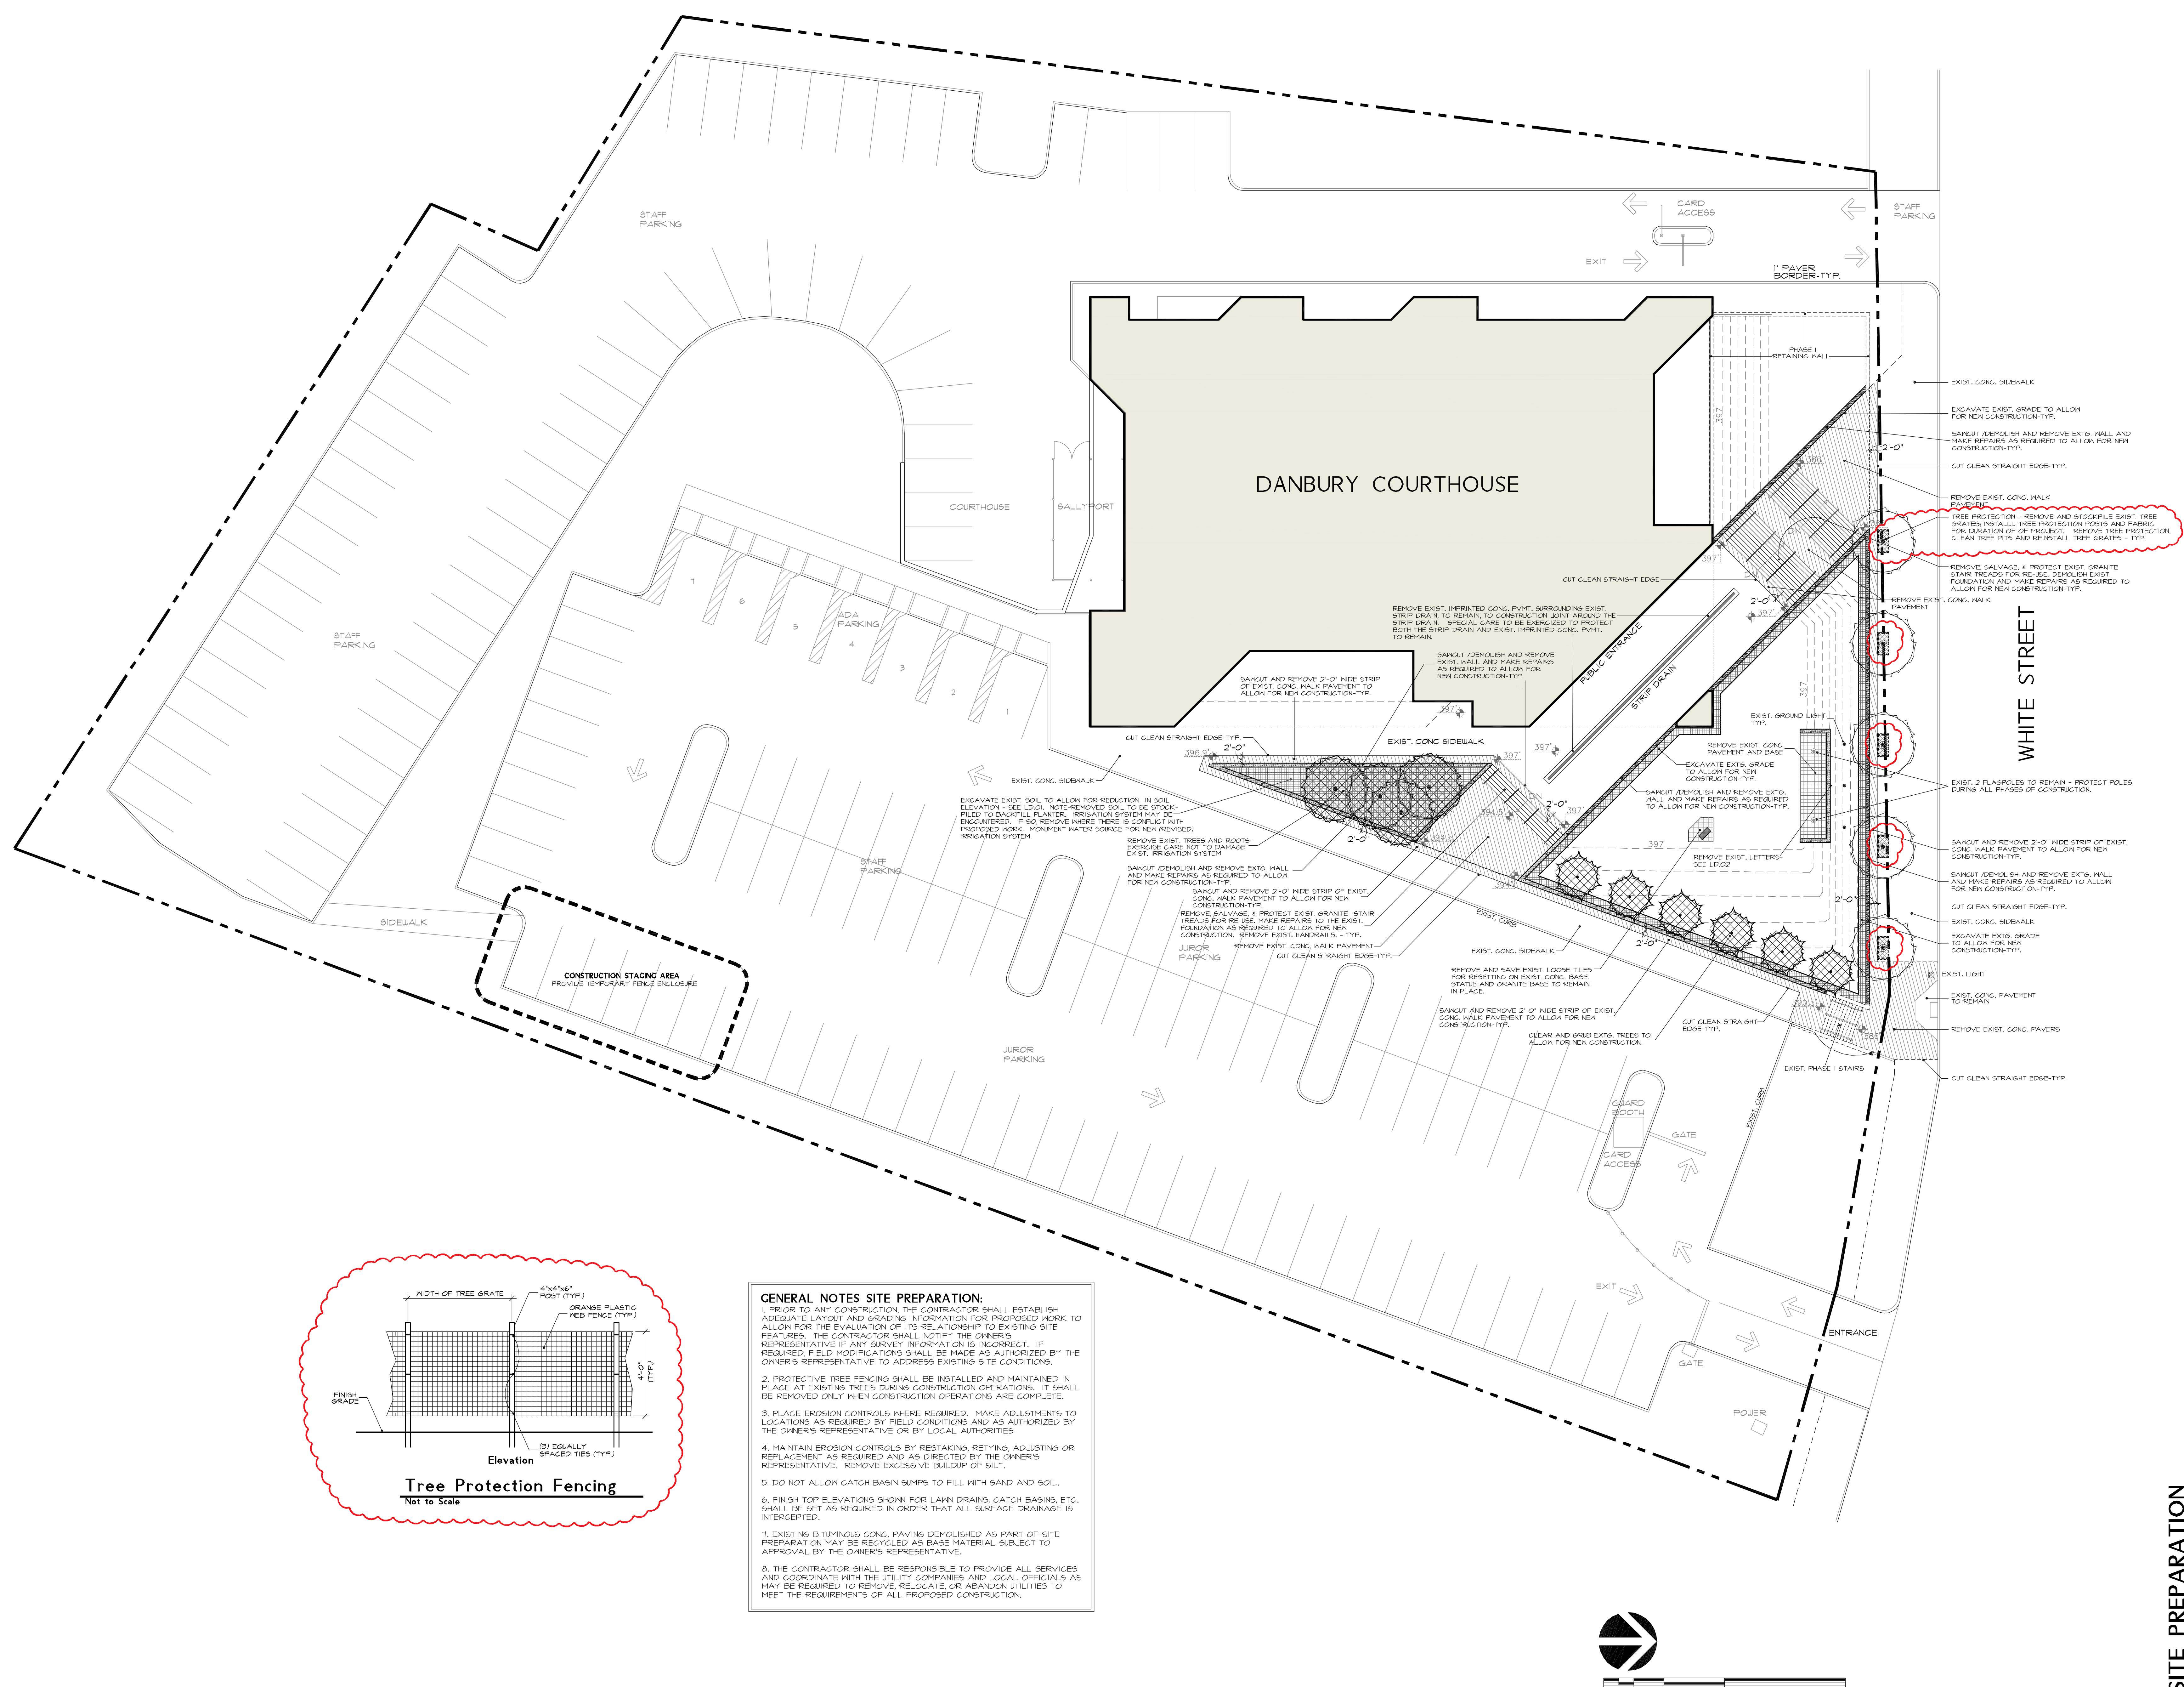

Tree Protection Fencing
Not to Scale

GENERAL NOTES SITE PREPARATION:

1. PRIOR TO ANY CONSTRUCTION, THE CONTRACTOR SHALL ESTABLISH ADEQUATE LAYOUT AND GRADING INFORMATION FOR PROPOSED WORK TO ALLOW FOR THE EVALUATION OF ITS RELATIONSHIP TO EXISTING SITE FEATURES. THE CONTRACTOR SHALL NOTIFY THE OWNER'S REPRESENTATIVE IF ANY SURVEY INFORMATION IS INCORRECT. IF REQUIRED, FIELD MODIFICATIONS SHALL BE MADE AS AUTHORIZED BY THE OWNER'S REPRESENTATIVE TO ADDRESS EXISTING SITE CONDITIONS.
2. PROTECTIVE TREE FENCING SHALL BE INSTALLED AND MAINTAINED IN PLACE AT EXISTING TREES DURING CONSTRUCTION OPERATIONS. IT SHALL BE REMOVED ONLY WHEN CONSTRUCTION OPERATIONS ARE COMPLETE.
3. PLACE EROSION CONTROLS WHERE REQUIRED. MAKE ADJUSTMENTS TO LOCATIONS AS REQUIRED BY FIELD CONDITIONS AND AS AUTHORIZED BY THE OWNER'S REPRESENTATIVE OR BY LOCAL AUTHORITIES.
4. MAINTAIN EROSION CONTROLS BY RESTAKING, RETYING, ADJUSTING OR REPLACEMENT AS REQUIRED AND AS DIRECTED BY THE OWNER'S REPRESENTATIVE. REMOVE EXCESSIVE BUILDUP OF SILT.
5. DO NOT ALLOW CATCH BASIN SUMPS TO FILL WITH SAND AND SOIL.
6. FINISH TOP ELEVATIONS SHOWN FOR LAWN DRAINS, CATCH BASINS, ETC. SHALL BE SET AS REQUIRED IN ORDER THAT ALL SURFACE DRAINAGE IS INTERCEPTED.
7. EXISTING BITUMINOUS CONC. PAVING DEMOLISHED AS PART OF SITE PREPARATION MAY BE RECYCLED AS BASE MATERIAL SUBJECT TO APPROVAL BY THE OWNER'S REPRESENTATIVE.
8. THE CONTRACTOR SHALL BE RESPONSIBLE TO PROVIDE ALL SERVICES AND COORDINATE WITH THE UTILITY COMPANIES AND LOCAL OFFICIALS AS MAY BE REQUIRED TO REMOVE, RELOCATE, OR ABANDON UTILITIES TO MEET THE REQUIREMENTS OF ALL PROPOSED CONSTRUCTION.

SITE PREPARATION